

NORTH HIGHLAND AVE.

HOWELL ST.

BOULEVARD

DOT traffic barricades

Phase 5: solar street lighting

10' wide gates to permit maintenance and lawn mower

dog park rules signage

144'-2"

10' wide gate to permit lawn mower

Phase 3: Benches

10' x 10' dog safe entry/exit area.

69'-6"

dog bag dipenser

waste

10' x 10' dog safe entry/exit area.

dog bag dipenser

phase 2 water access and concrete pad

approx. location of city storm drain

337'-8"

existing water meter

174'-6"

64'-3"

dog bag dipenser


Phase 3: Benches

dog bag dipenser

-fence posts avoid existing tree roots typical @ all trees

passive security car views to park

setbacks vary to avoid tree roots -typical

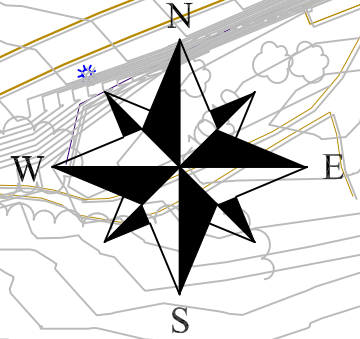

- LEGEND**
- existing road signs
 - existing street lights
 - existing trees

FREEDOM BARKWAY
freedombarkway.com

In the Heart of Old 4th Ward

SCALE:

DSGN: XXX	DATE: 2015/04/23
DWN: XXX	
CHKD: XXX	
SHEET 1 OF 1	DRAWN BY: HAStudio.com